
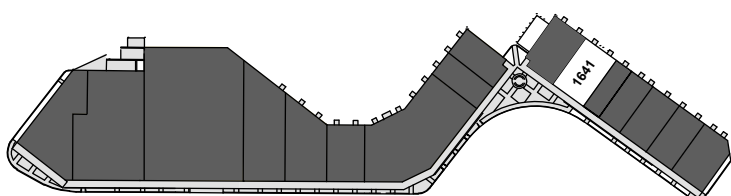


# Chesterfield Crossing

1641 Clarkson Road

As-Built 2,400 Sq. Ft.

\* Dimensions are Deemed  
as Accurate but not to Scale

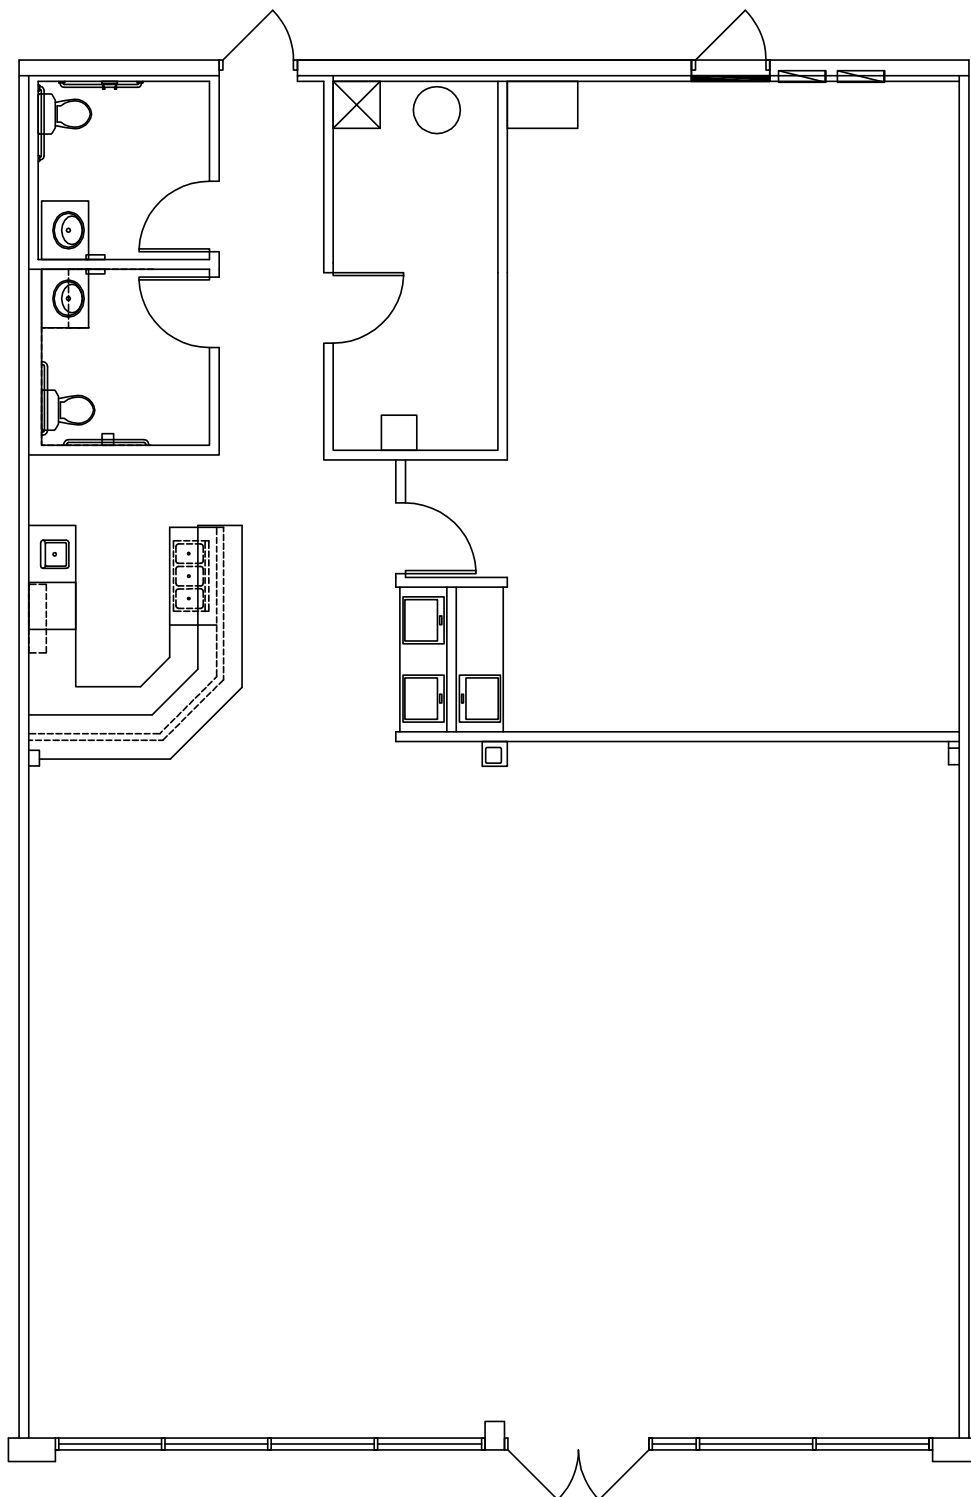

OWNED & MANAGED BY



LEASED BY

