



Chesterfield Crossing

1655 Clarkson Road

As-Built 1,800 Sq. Ft.

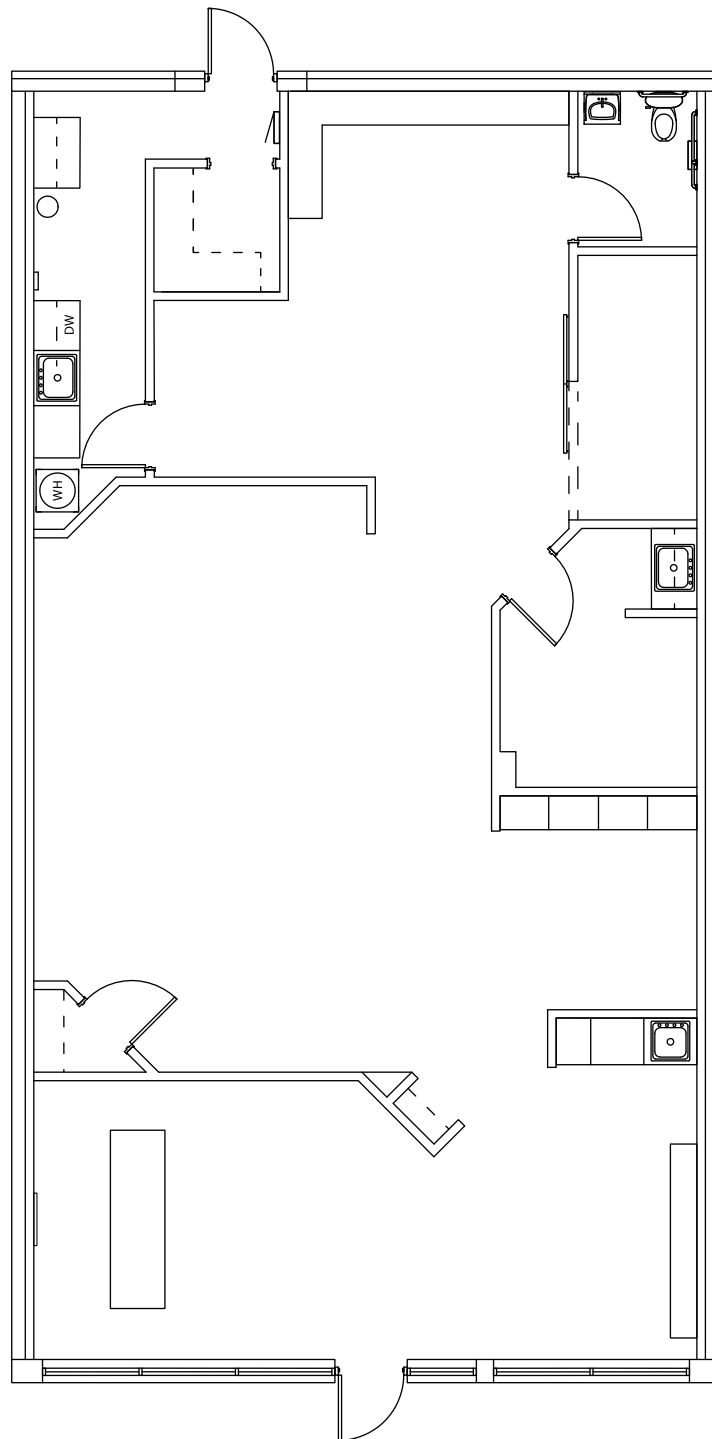

** Dimensions are Deemed
as Accurate but not to Scale*

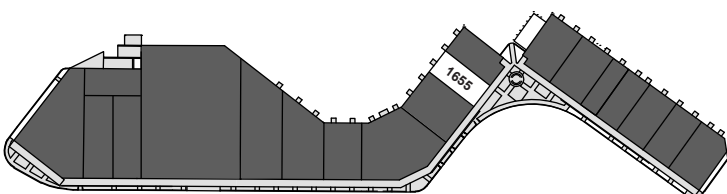

OWNED & MANAGED BY



LEASED BY

