


Lakeside Shoppes at Winghaven

3070 Winghaven Blvd

As-Built 4,064 Sq. Ft.

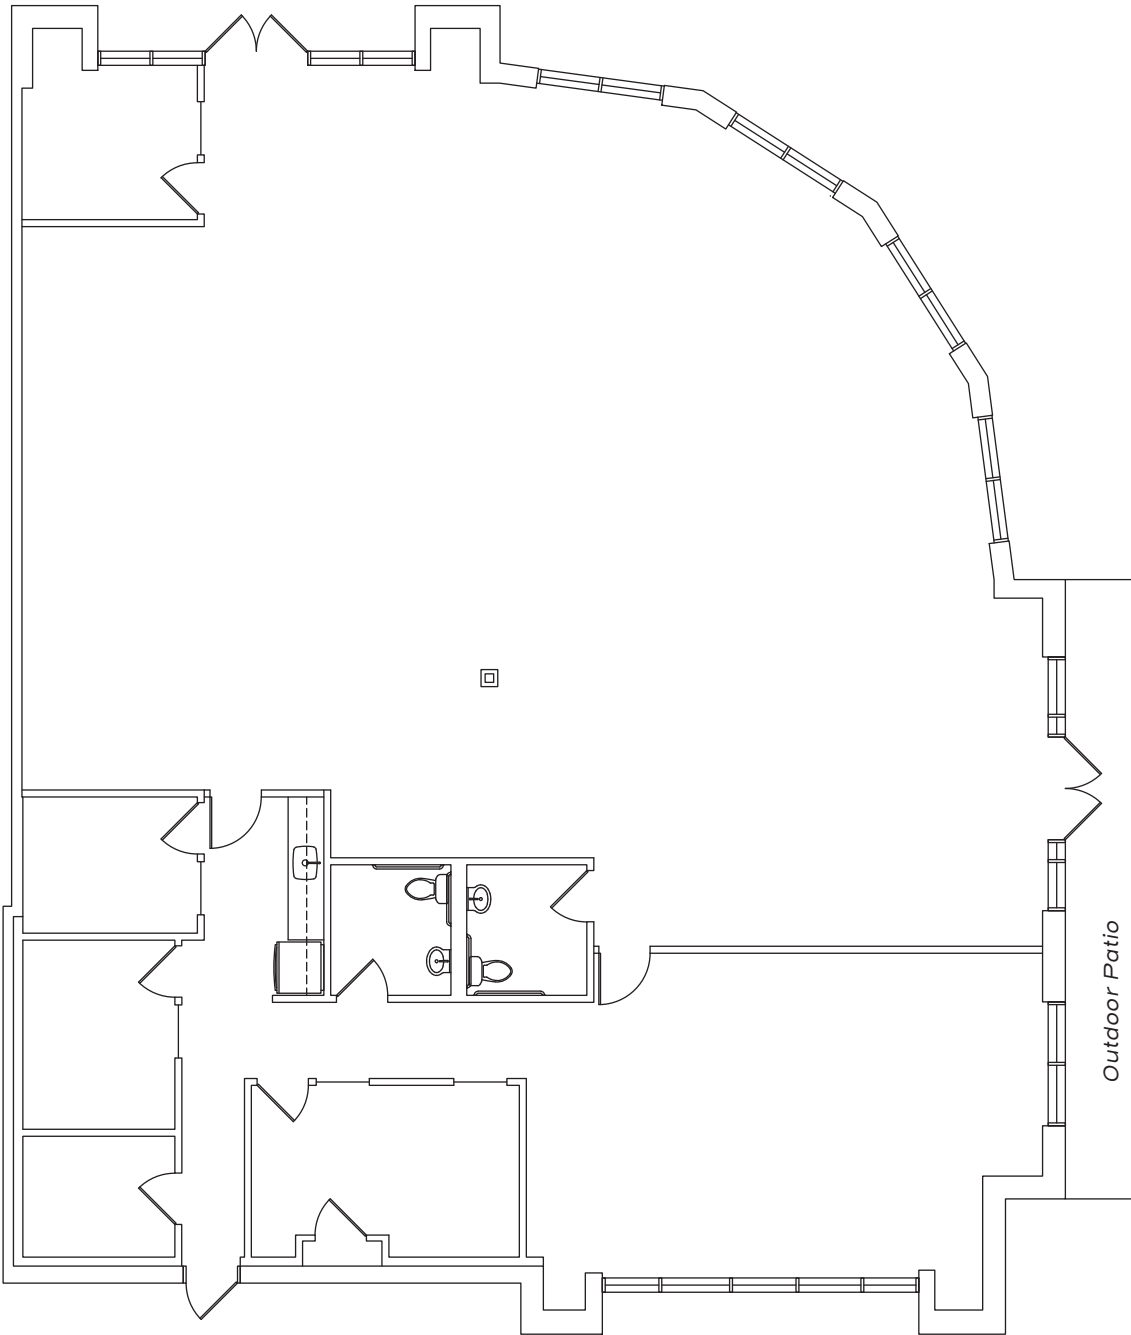

** Dimensions are Deemed
as Accurate but not to Scale*



OWNED & MANAGED BY



LEASED BY

